

10th Floor | 29,032 RSF


5 2 5

LOW-RISE FLOOR

MARKET

Available Now (Subject to Lease Termination)

Market Street

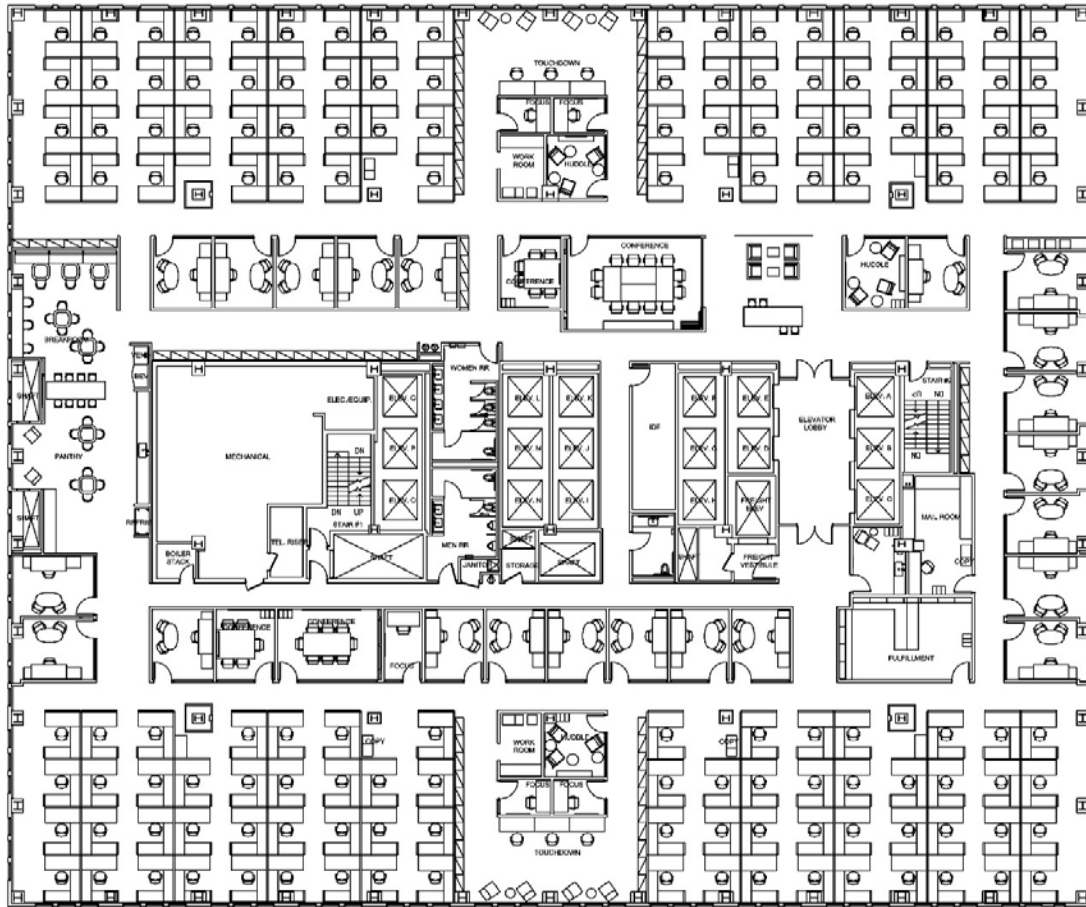

First Street

As-Built

- ±136 workstations
- 22 offices/small meeting rooms
- 4 conference rooms
- Open areas
- Huddle and focus rooms
- Large entertainment kitchen
- IT room
- Mother's room
- Storage
- Full HVAC

JD LUMPKIN

+1 415 658 3648

jd.lumpkin@cushwake.com

Lic. #01215057

MARK ANDERSON

+1 415 713 1014

mark.anderson@cushwake.com

Lic. #01325399

