
## 11th Floor | 29,031 RSF

MARKET

LOW-RISE FLOOR

Available Now

## Market Street

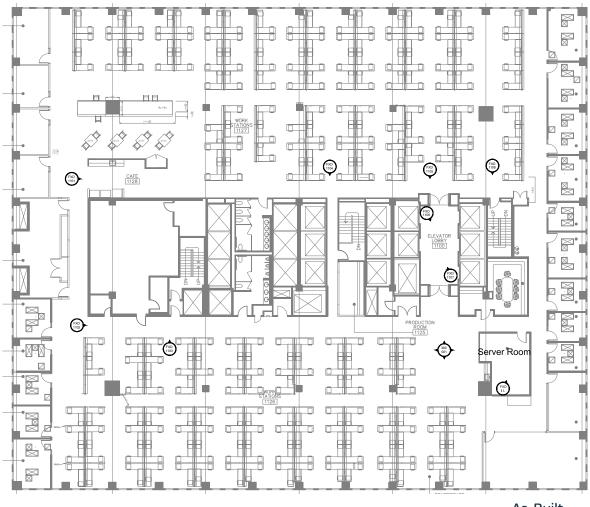

As-Built

- Available Now
- Full Floor Identity

## JD LUMPKIN

+1 415 658 3648 jd.lumpkin@cushwake.com Lic. #01215057

+1 415 713 1014 mark.anderson@cushwake.com Lic. #01325399

