

28th Floor | 16,603 RSF


5 2 5

HIGH-RISE FLOOR

MARKET

Available Now (Subject to Lease Termination)

Market Street

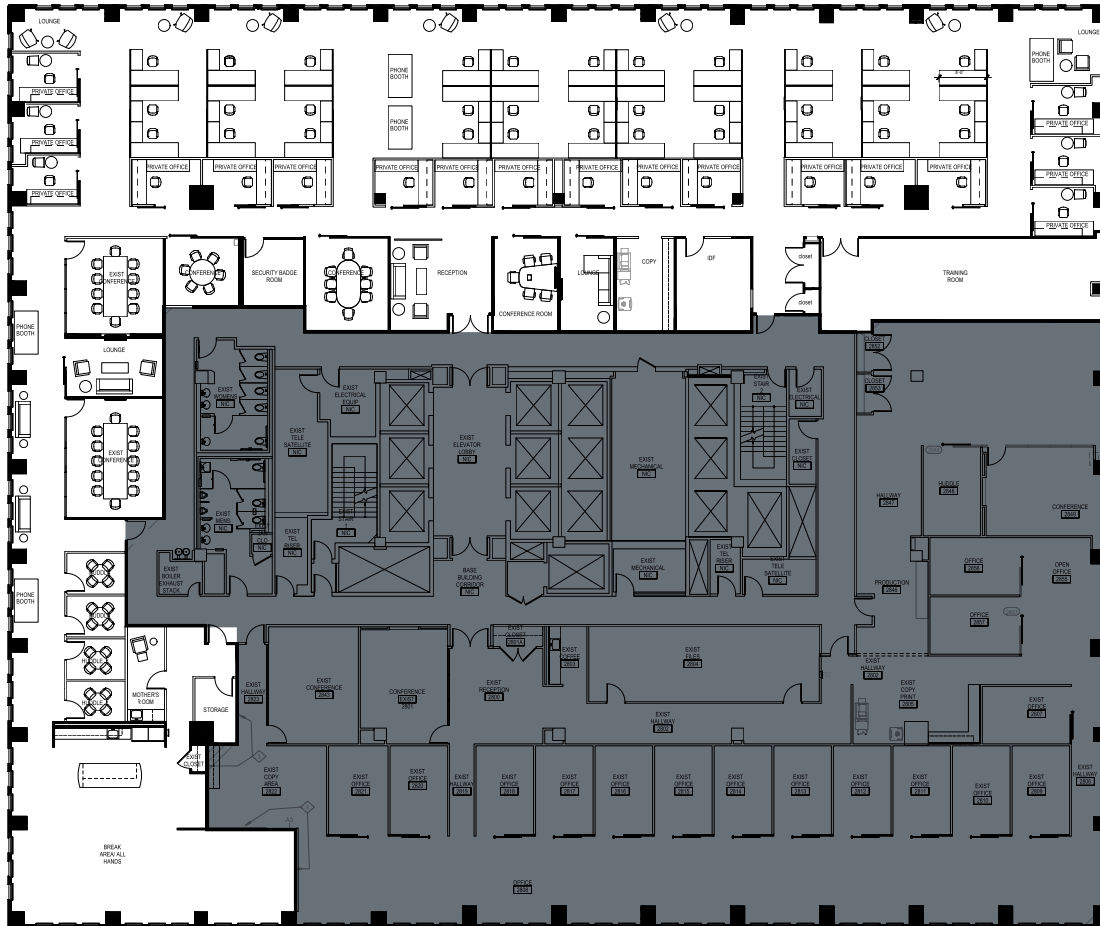

First Street

As-Built

- Available Now (Subject to lease termination)
- 18 Private Offices
- 5 Conference Rooms
- 1 Training Room
- 4 Phone Booths
- Large Break Area/All Hands
- Mother's Room



CLICK OR
SCAN FOR
360 TOUR

JD LUMPKIN

+1 415 658 3648

jd.lumpkin@cushwake.com

Lic. #01215057

MARK ANDERSON

+1 415 713 1014

mark.anderson@cushwake.com

Lic. #01325399

