

28th Floor | 16,603 RSF


5 2 5

HIGH-RISE FLOOR

MARKET

Available Now (Subject to Lease Termination)

Market Street

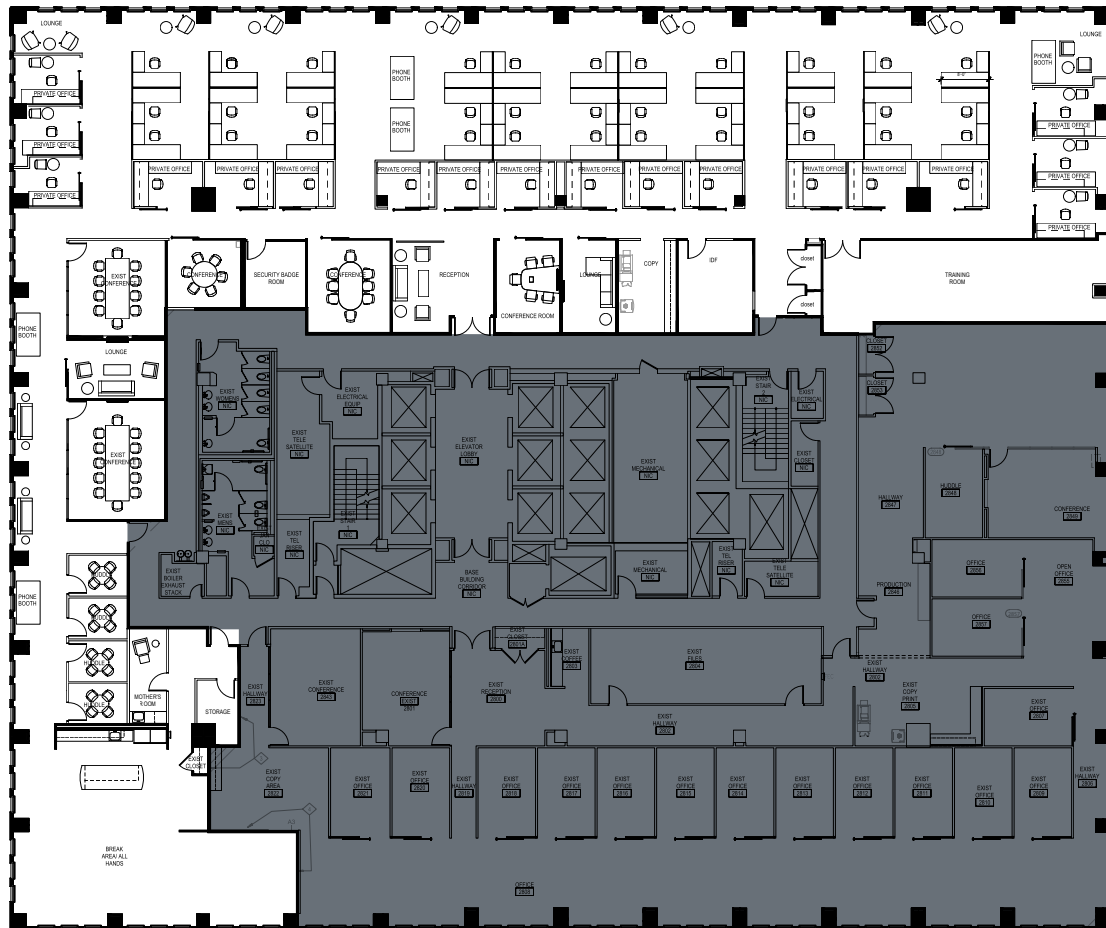

First Street

As-Built

- Available Now (Subject to lease termination)
- 18 Private Offices
- 5 Conference Rooms
- 1 Training Room
- 4 Phone Booths
- Large Break Area/All Hands
- Mother's Room



CLICK OR
SCAN FOR
360 TOUR

JD LUMPKIN

+1 415 658 3648

jd.lumpkin@cushwake.com

Lic. #01215057

MARK ANDERSON

+1 415 713 1014

mark.anderson@cushwake.com

Lic. #01325399

 CUSHMAN & WAKEFIELD

©2025 Cushman & Wakefield. All rights reserved. The information contained in this communication is strictly confidential. This information has been obtained from sources believed to be reliable but has not been verified. NO WARRANTY OR REPRESENTATION, EXPRESS OR IMPLIED, IS MADE AS TO THE CONDITION OF THE PROPERTY (OR PROPERTIES) REFERENCED HEREIN OR AS TO THE ACCURACY OR COMPLETENESS OF THE INFORMATION CONTAINED HEREIN, AND SAME IS SUBMITTED SUBJECT TO ERRORS, OMISSIONS, CHANGE OF PRICE, RENTAL OR OTHER CONDITIONS, WITHDRAWAL WITHOUT NOTICE, AND TO ANY SPECIAL LISTING CONDITIONS IMPOSED BY THE PROPERTY OWNER(S). ANY PROJECTIONS, OPINIONS OR ESTIMATES ARE SUBJECT TO UNCERTAINTY AND DO NOT SIGNIFY CURRENT OR FUTURE PROPERTY PERFORMANCE. COE-PM-West-01.14.2025