
## Interstate 90 Northeast Gilman Boulevard Driveway **Neighboring Commercial Buildings**

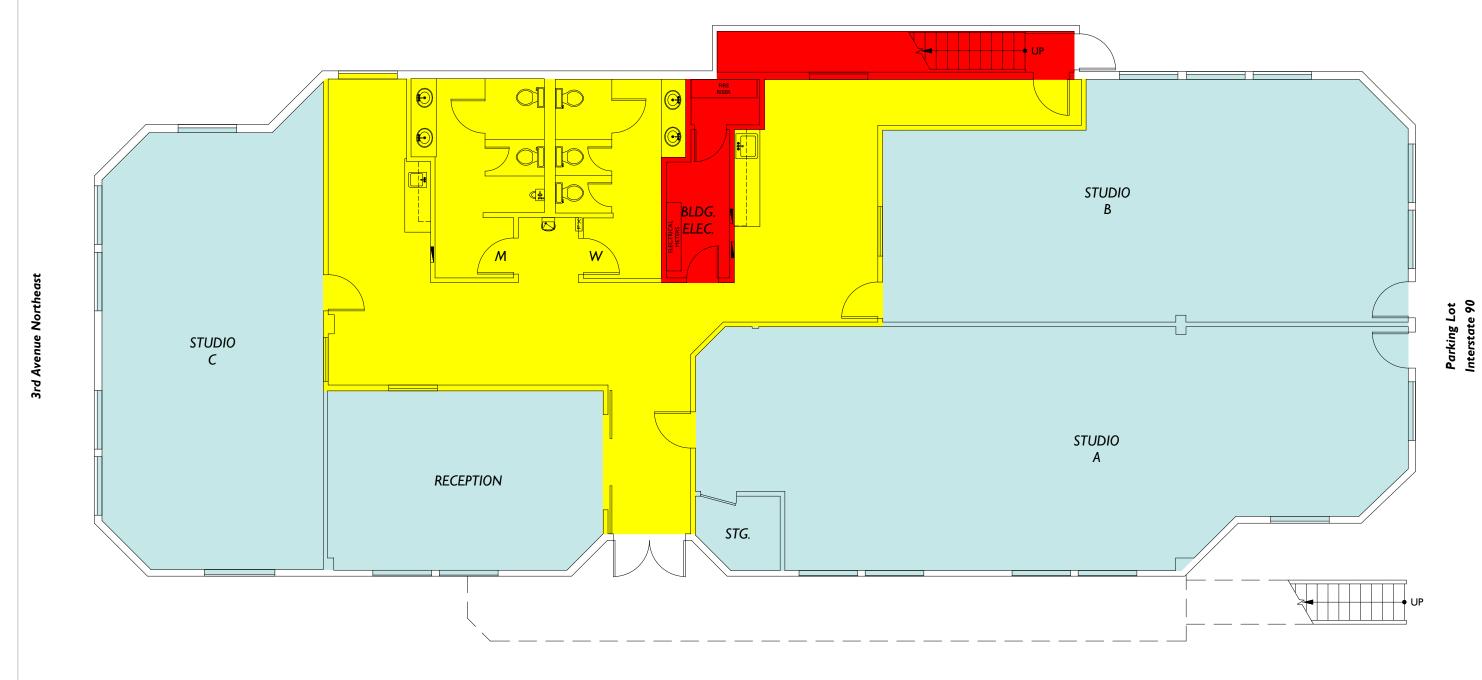

**FLOOR PLANS** 

2DFLOORPLANS.COM

600 NW Gilman Blvd. Suite E Issaquah, WA 98027 425-677-7511

This drawing is an instrument of service and is the sole property of the client listed. Any alteration of this drawing without removal of references to 2-D As-Built Floor Plans, Inc. is prohibited.

©2010 2-D As-Built Floor Plans, Inc. All Rights Reserved.

Area Analysis performed in accordance with ANSI/BOMA Z65.1 - 2017 Method A Standard.

## Project: C22-510


Date	Action
Project	
4/28/2022	Initial Building Measure
C22-510	

Client:

Stetz Commercial Properties

Site:

Office Building 320 3rd Avenue Northeast Issaquah, WA 98027

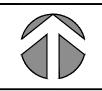

Lease Plan



Scale: 1/8" = 1'-0"

**Occupant Rentable** Suite # Area 1,473.38

Driveway **Neighboring Commercial Building** Issaquah Creek - East Fork Northeast Birch Street

Floor Summary SQ. FT. Total Rentable Area

Floor Service Area

4,293.23 2,984.18 Total Occupant Area Load Factor 1.438663

> 1,195.52 Floor I West 1,024.13 1,960.05 2,819.85 Floor I East